


PROJECT LOCATION

6701 EVANSTAD DR N
MAPLE GROVE, MN 55369

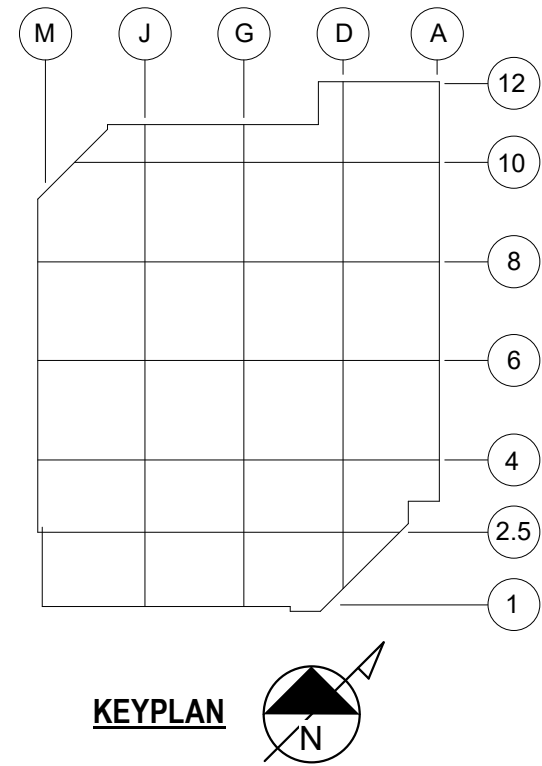

CLIENT

UPSHER-SMITH

Partners in Health Since 1919

CONSULTING ENGINEER

HORWITZ

7400 49th AVENUE NORTH
NEW HOPE, MN 55428
(763) 533-1900
www.horwitzinc.com

PROJECT TITLE

**PROJECT KEYSTONE
PHASE 1**

REV	BY	DATE	DESCRIPTION
0	RS	1/15/2021	AS BUILT
1		03/25/22	AS RECORDED

LICENSEE

I HEREBY CERTIFY THAT THIS PLAN, SPECIFICATION OR REPORT WAS PREPARED BY ME OR UNDER MY DIRECT SUPERVISION AND THAT I AM A DULY LICENSED ENGINEER UNDER THE LAWS OF THE STATE OF MINNESOTA.

TODD MATELSKI
Date 03/25/22 LIC NO 50819

CONFIDENTIAL - THIS DRAWING IS THE PROPERTY OF UPSHER-SMITH. THE INFORMATION CONTAINED HEREIN MAY NOT BE USED OR COPIED IN ANY MANNER WITHOUT THE WRITTEN PERMISSION OF THE OWNER.


PROJ. NO.	2022.1720	DESIGNED BY:	Designer
SCALE:	1/8" = 1'-0"	CHECKED BY:	Checker
SHEET SIZE:	30x42	APPROVED BY:	Approver

DRAWING TITLE

**MECHANICAL-PROCESS PIPING
PLAN-PUR01-LEVEL 2 AREA 1**

DRAWING NUMBER

M50-20-01

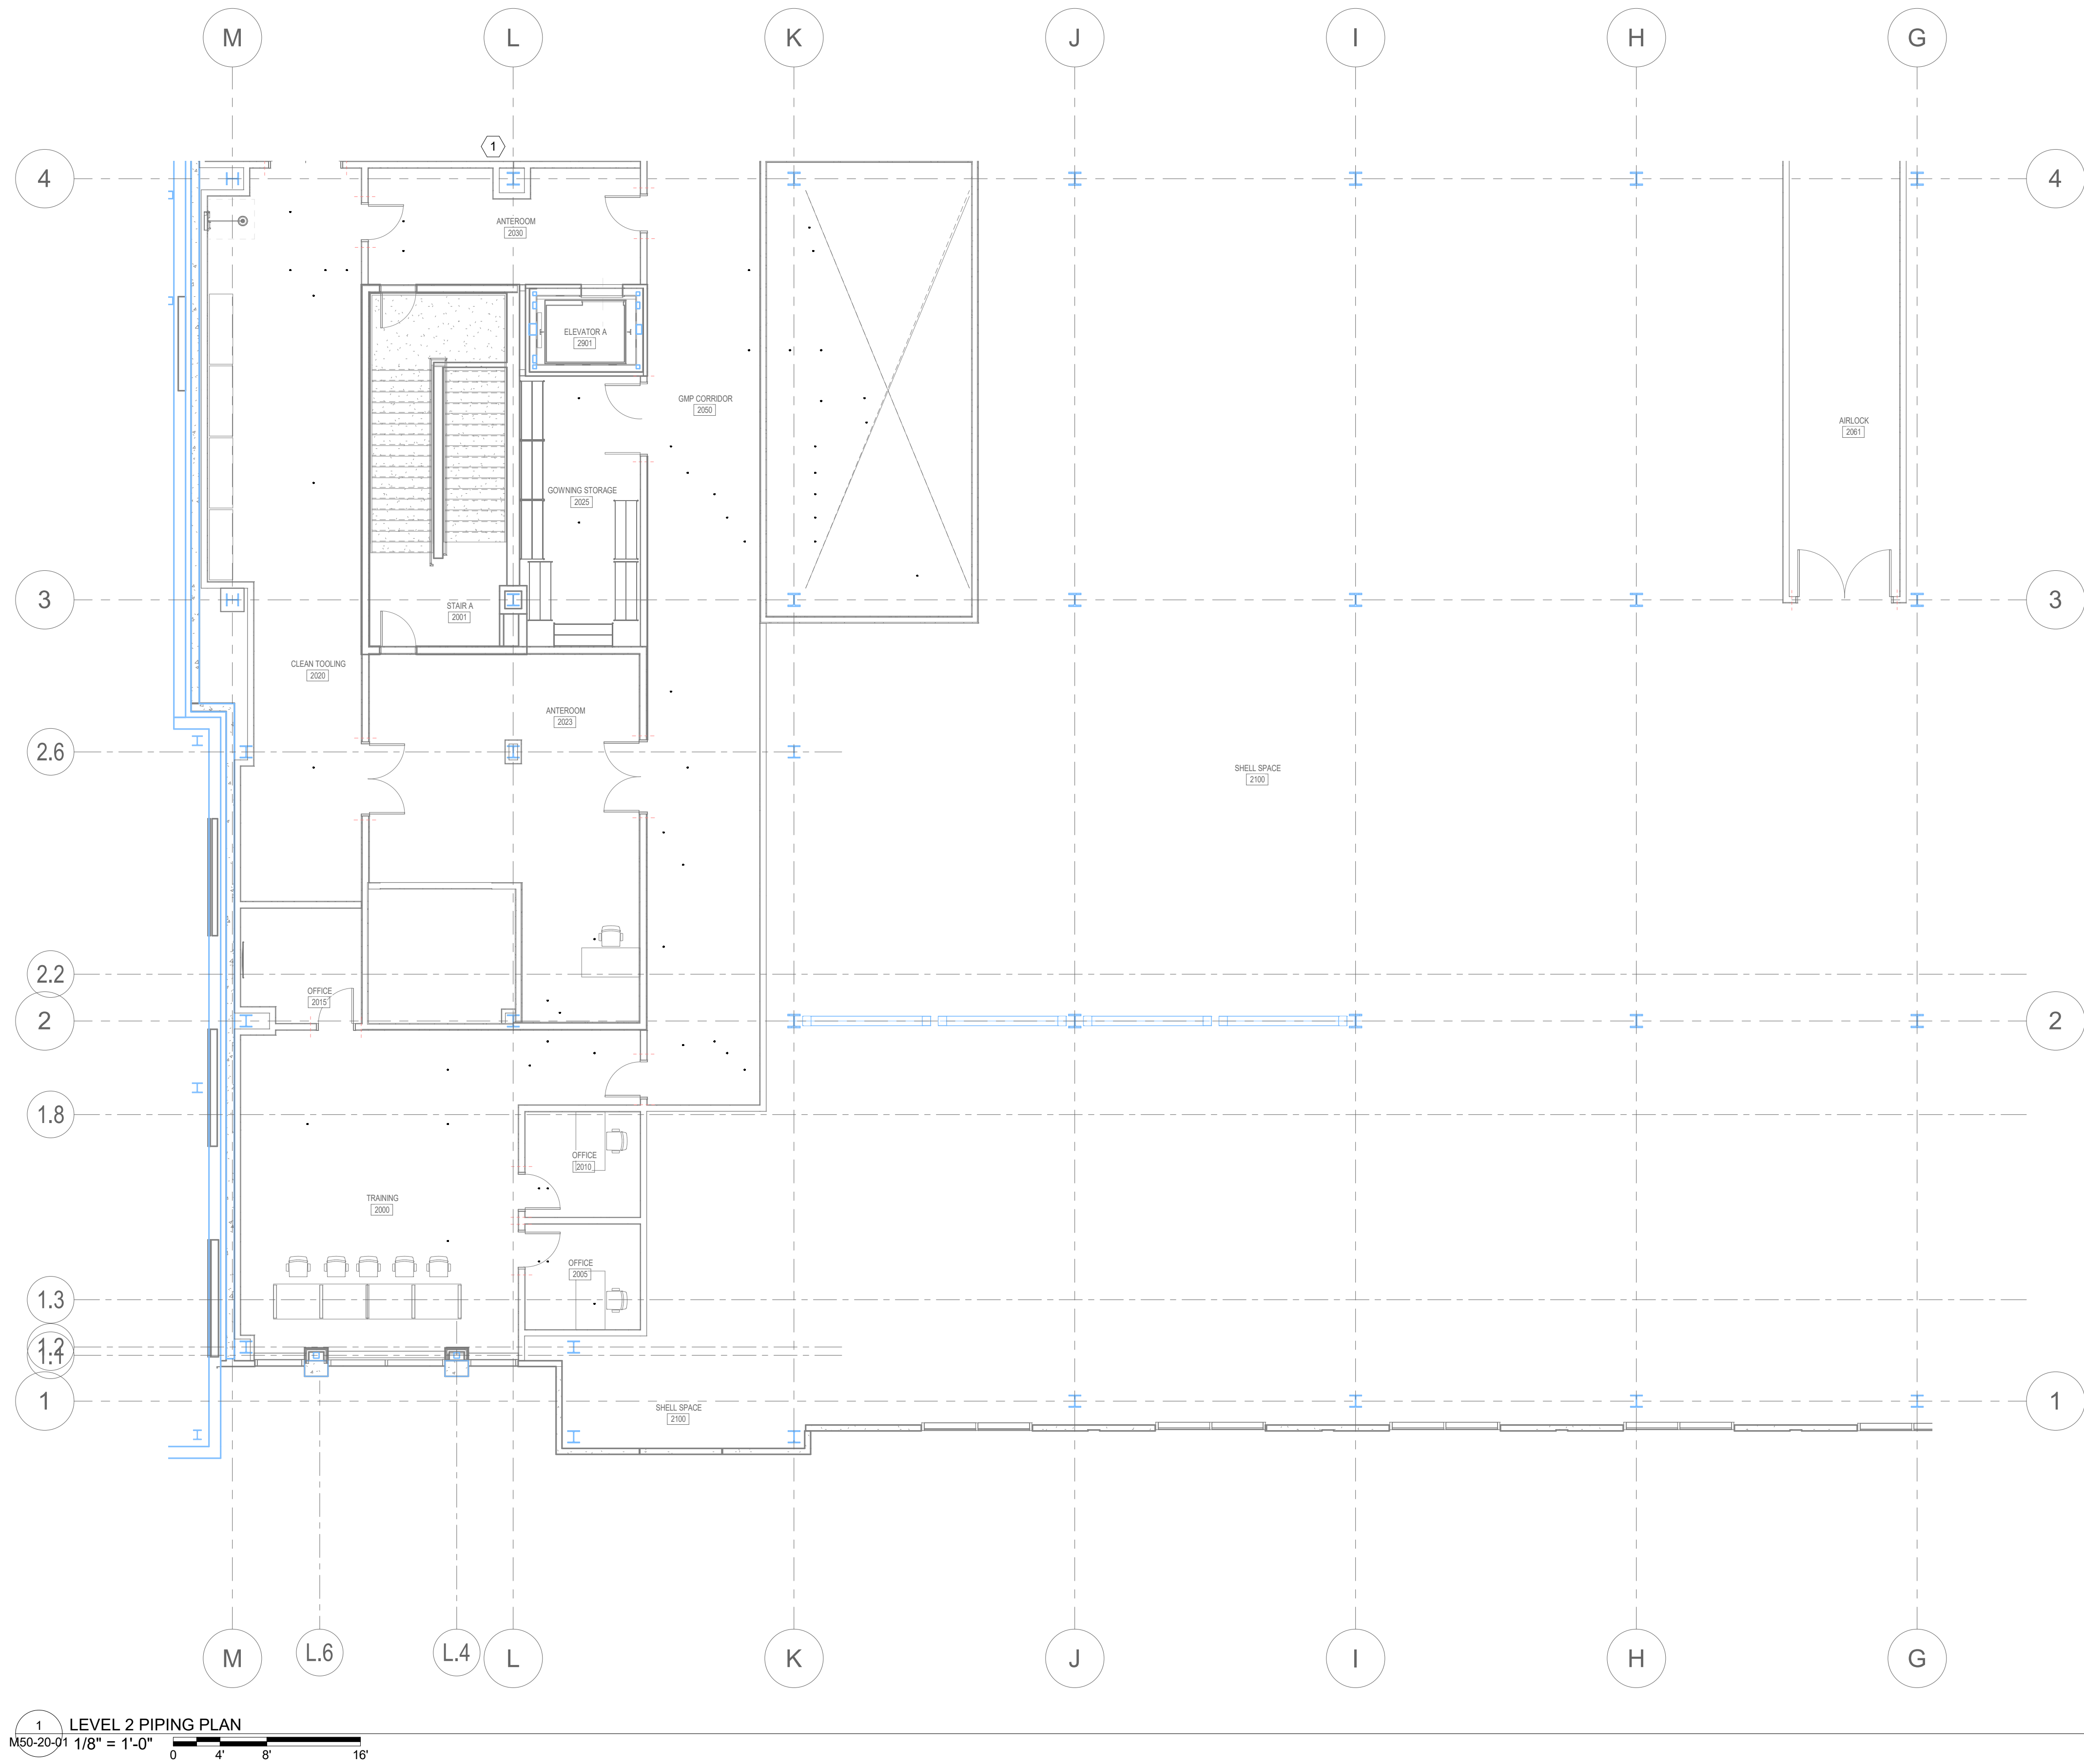

1 LEVEL 2 PIPING PLAN
M50-20-01 1/8" = 1'-0"