


1 LEVEL 3 PIPING PLAN  
M54-30-01 1/8" = 1'-0"

PROJECT LOCATION

6701 EVANSTAD DR N  
MAPLE GROVE, MN 55369

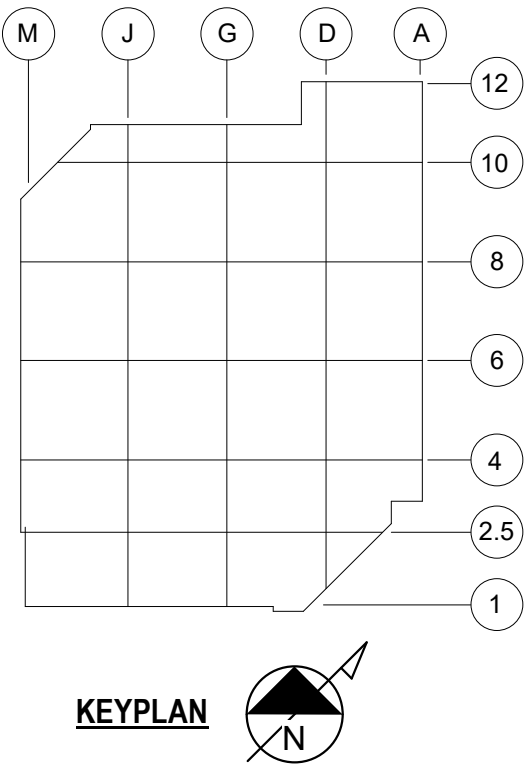

CLIENT

**UPSHER-SMITH**

*Partners in Health Since 1919*

CONSULTING ENGINEER

**HORWITZ**

7400 49th AVENUE NORTH  
NEW HOPE, MN 55428  
(763) 533-1900  
www.horwitzinc.com

PROJECT TITLE

PROJECT KEYSTONE  
PHASE 1

REV	BY	DATE	DESCRIPTION
0	RS	17DEC21	AS BUILT
1	RS	06/03/22	AS RECORDED

LICENSEE

I HEREBY CERTIFY THAT THIS PLAN, SPECIFICATION OR REPORT WAS PREPARED BY ME OR UNDER MY DIRECT SUPERVISION AND THAT I AM A DULY LICENSED ENGINEER UNDER THE LAWS OF THE STATE OF MINNESOTA.

*T. Matelski*

TODD MATELSKI  
Date 06/03/22 LIC No 50819

CONFIDENTIAL - THIS DRAWING IS THE PROPERTY OF UPSHER-SMITH. THE INFORMATION CONTAINED HEREIN MAY NOT BE USED OR COPIED IN ANY MANNER WITHOUT THE WRITTEN PERMISSION OF THE OWNER.

PROJ. NO.	2022.1720	DESIGNED BY:	Designer
SCALE:	1/8" = 1'-0"	CHECKED BY:	Checker
SHEET SIZE:	30x42	APPROVED BY:	Approver

DRAWING TITLE

MECHANICAL-PROCESS PIPING  
PLAN-N201-LEVEL 3 AREA 1

DRAWING NUMBER

M54-30-01