


PROJECT LOCATION

6701 EVANSTAD DR N  
MAPLE GROVE, MN 55369



KEYPLAN

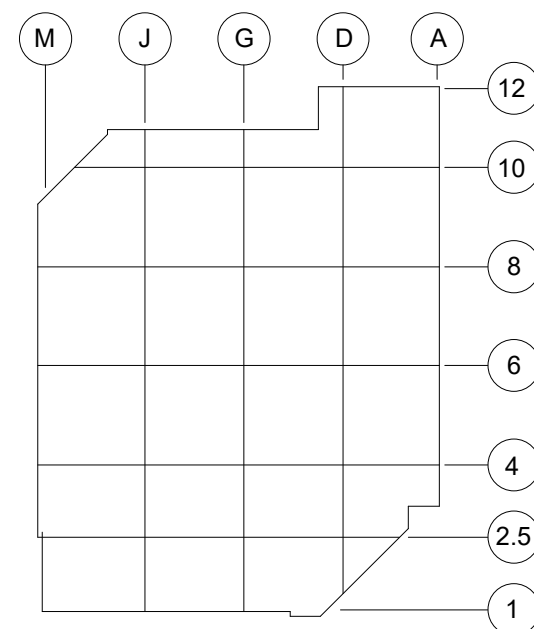

CLIENT

**UPSHER-SMITH**

Partners in Health Since 1919

CONSULTING ENGINEER



7400 49th AVENUE NORTH  
NEW HOPE, MN 55428  
(763) 533-1900  
www.horwitzinc.com

PROJECT TITLE

PROJECT KEYSTONE  
PHASE 1

REV	BY	DATE	DESCRIPTION
0	RS	1/10/2021	AS BUILT
1	RS	06/03/22	AS RECORDED

LICENSEE

I HEREBY CERTIFY THAT THIS PLAN,  
SPECIFICATION OR REPORT WAS  
PREPARED BY ME OR UNDER MY  
DIRECT SUPERVISION AND THAT I AM  
A DULY LICENSED ENGINEER UNDER  
THE LAWS OF THE STATE OF  
MINNESOTA.

*T. Matelski*  
TODD MATELSKI

Date 06/03/22 LIC No 50819

CONFIDENTIAL - THIS DRAWING IS THE PROPERTY OF UPSHER-SMITH. THE  
INFORMATION CONTAINED HEREIN MAY NOT BE USED OR COPIED IN ANY  
MANNER WITHOUT THE WRITTEN PERMISSION OF THE OWNER.

PROJ. NO.	2022.1720	DESIGNED BY:	Designer
SCALE:	1/8" = 1'-0"	CHECKED BY:	Checker
SHEET SIZE:	30x42	APPROVED BY:	Approver

DRAWING TITLE

MECHANICAL-PROCESS PIPING  
PLAN-CA01-LEVEL 3 AREA 1

DRAWING NUMBER

M51-30-01